
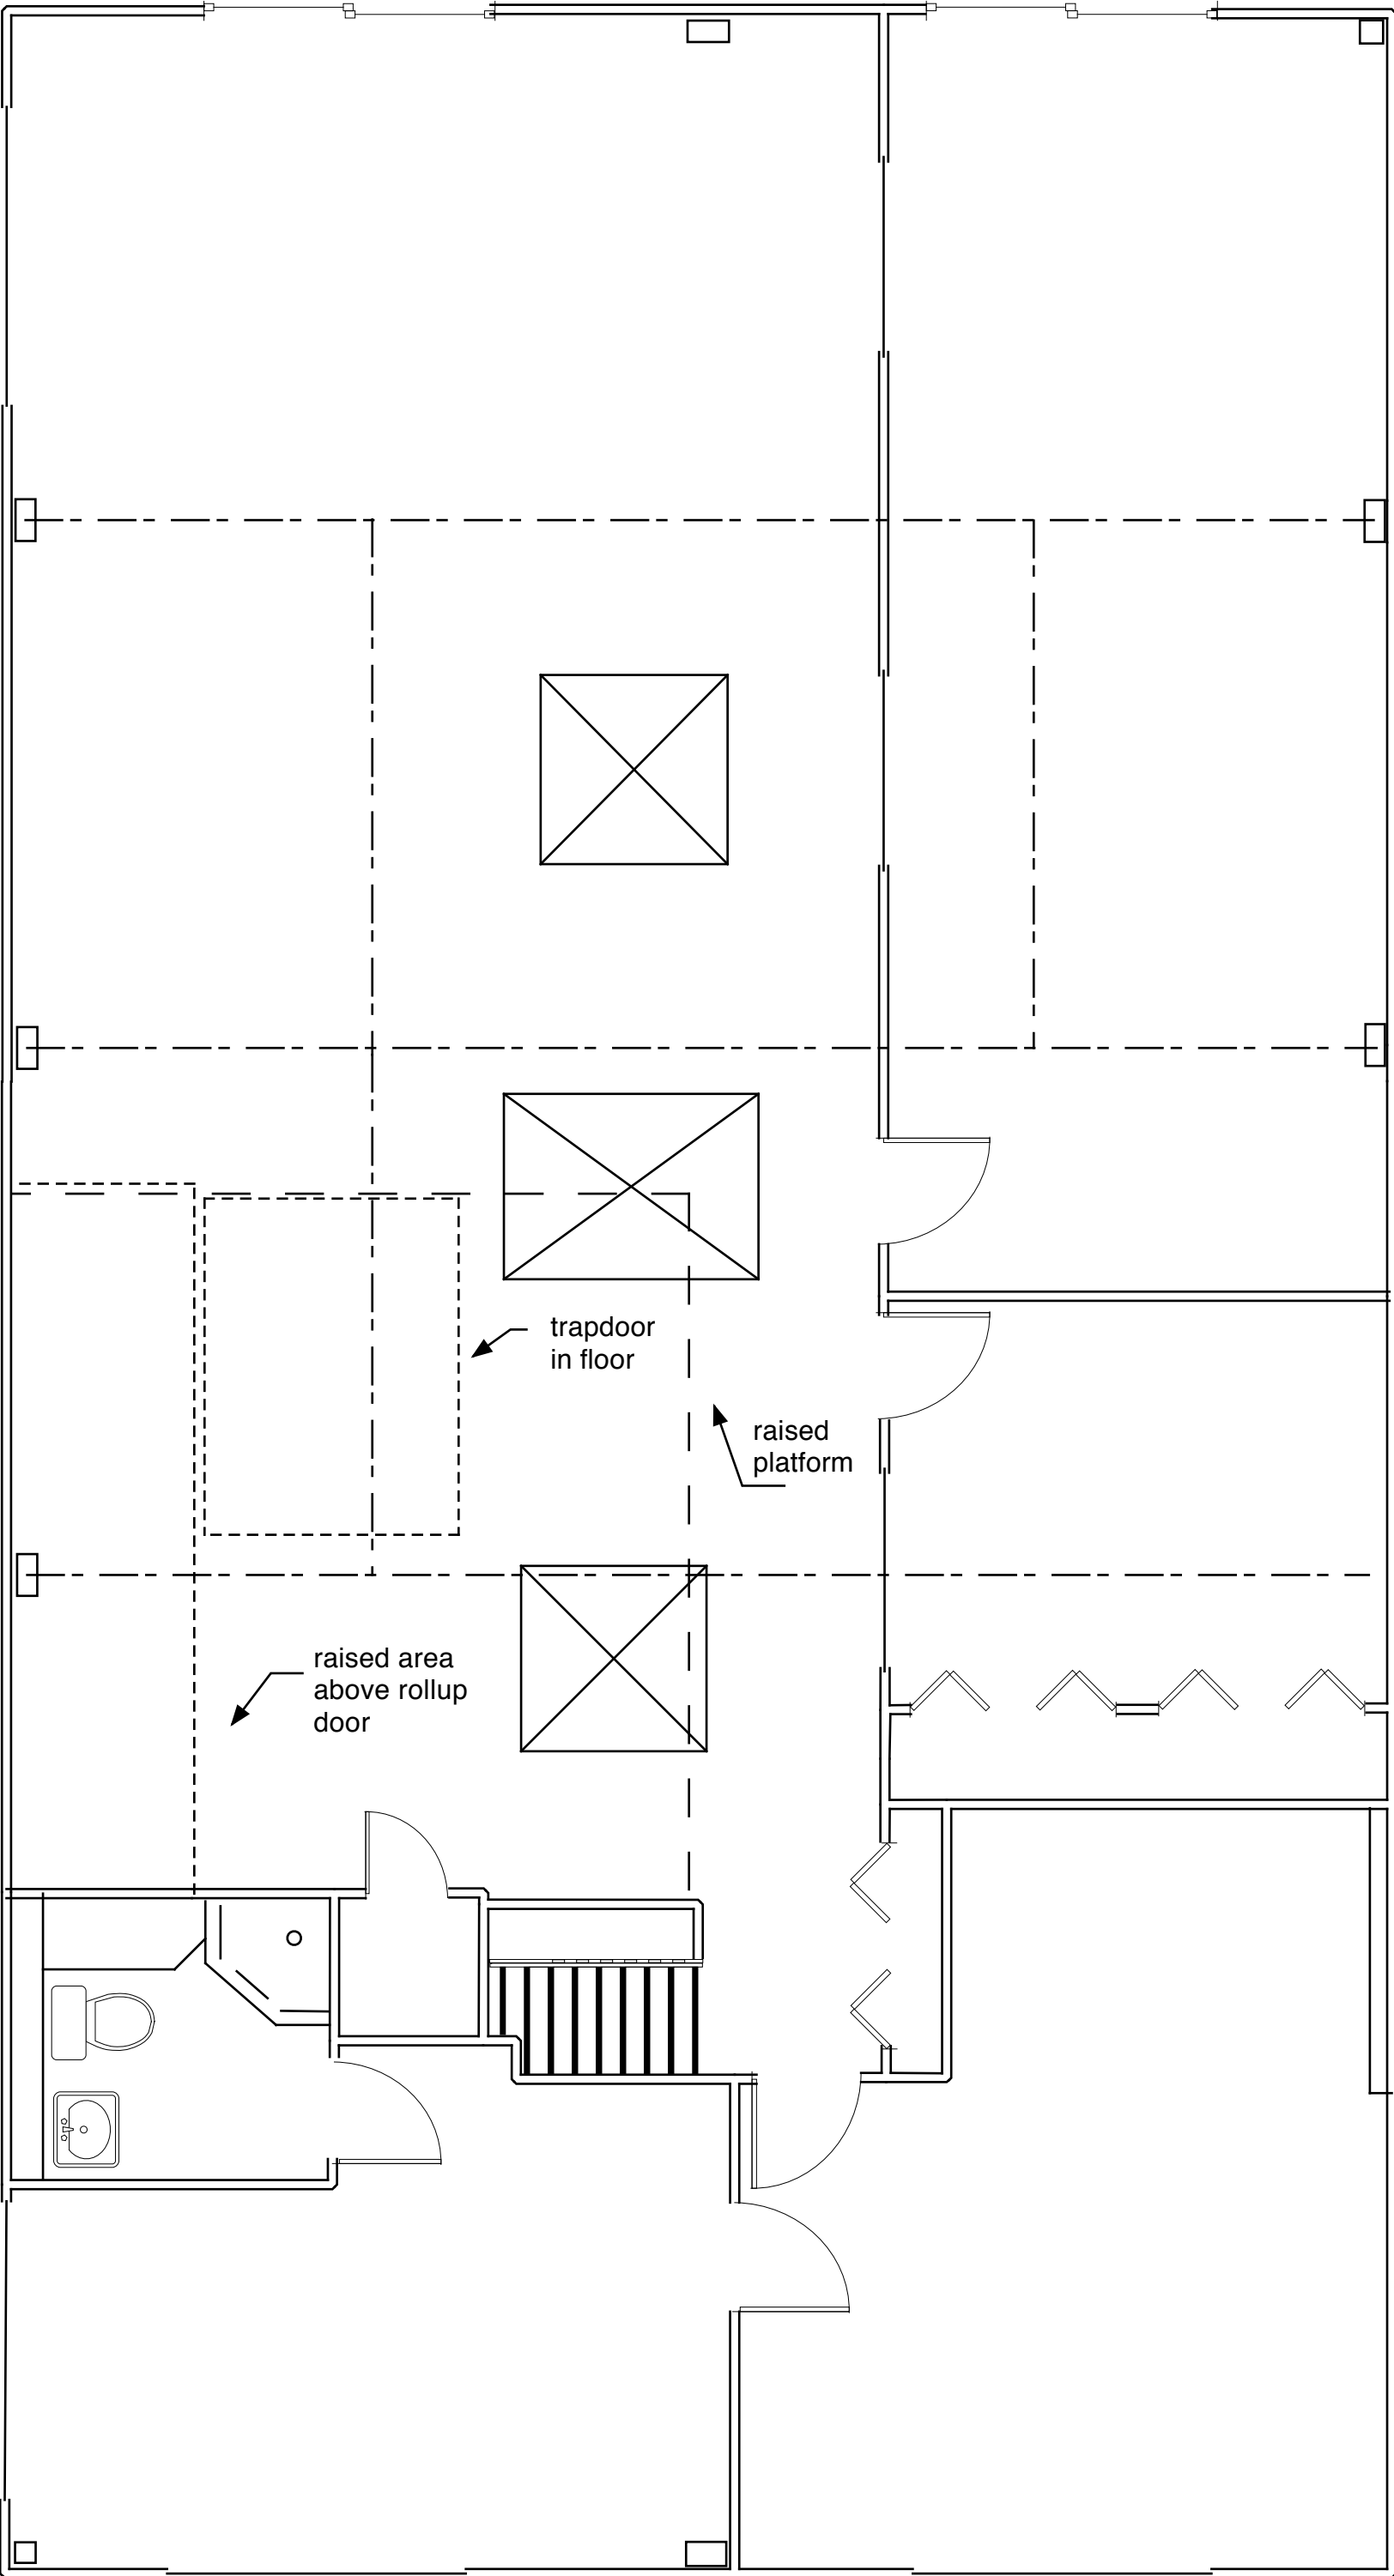


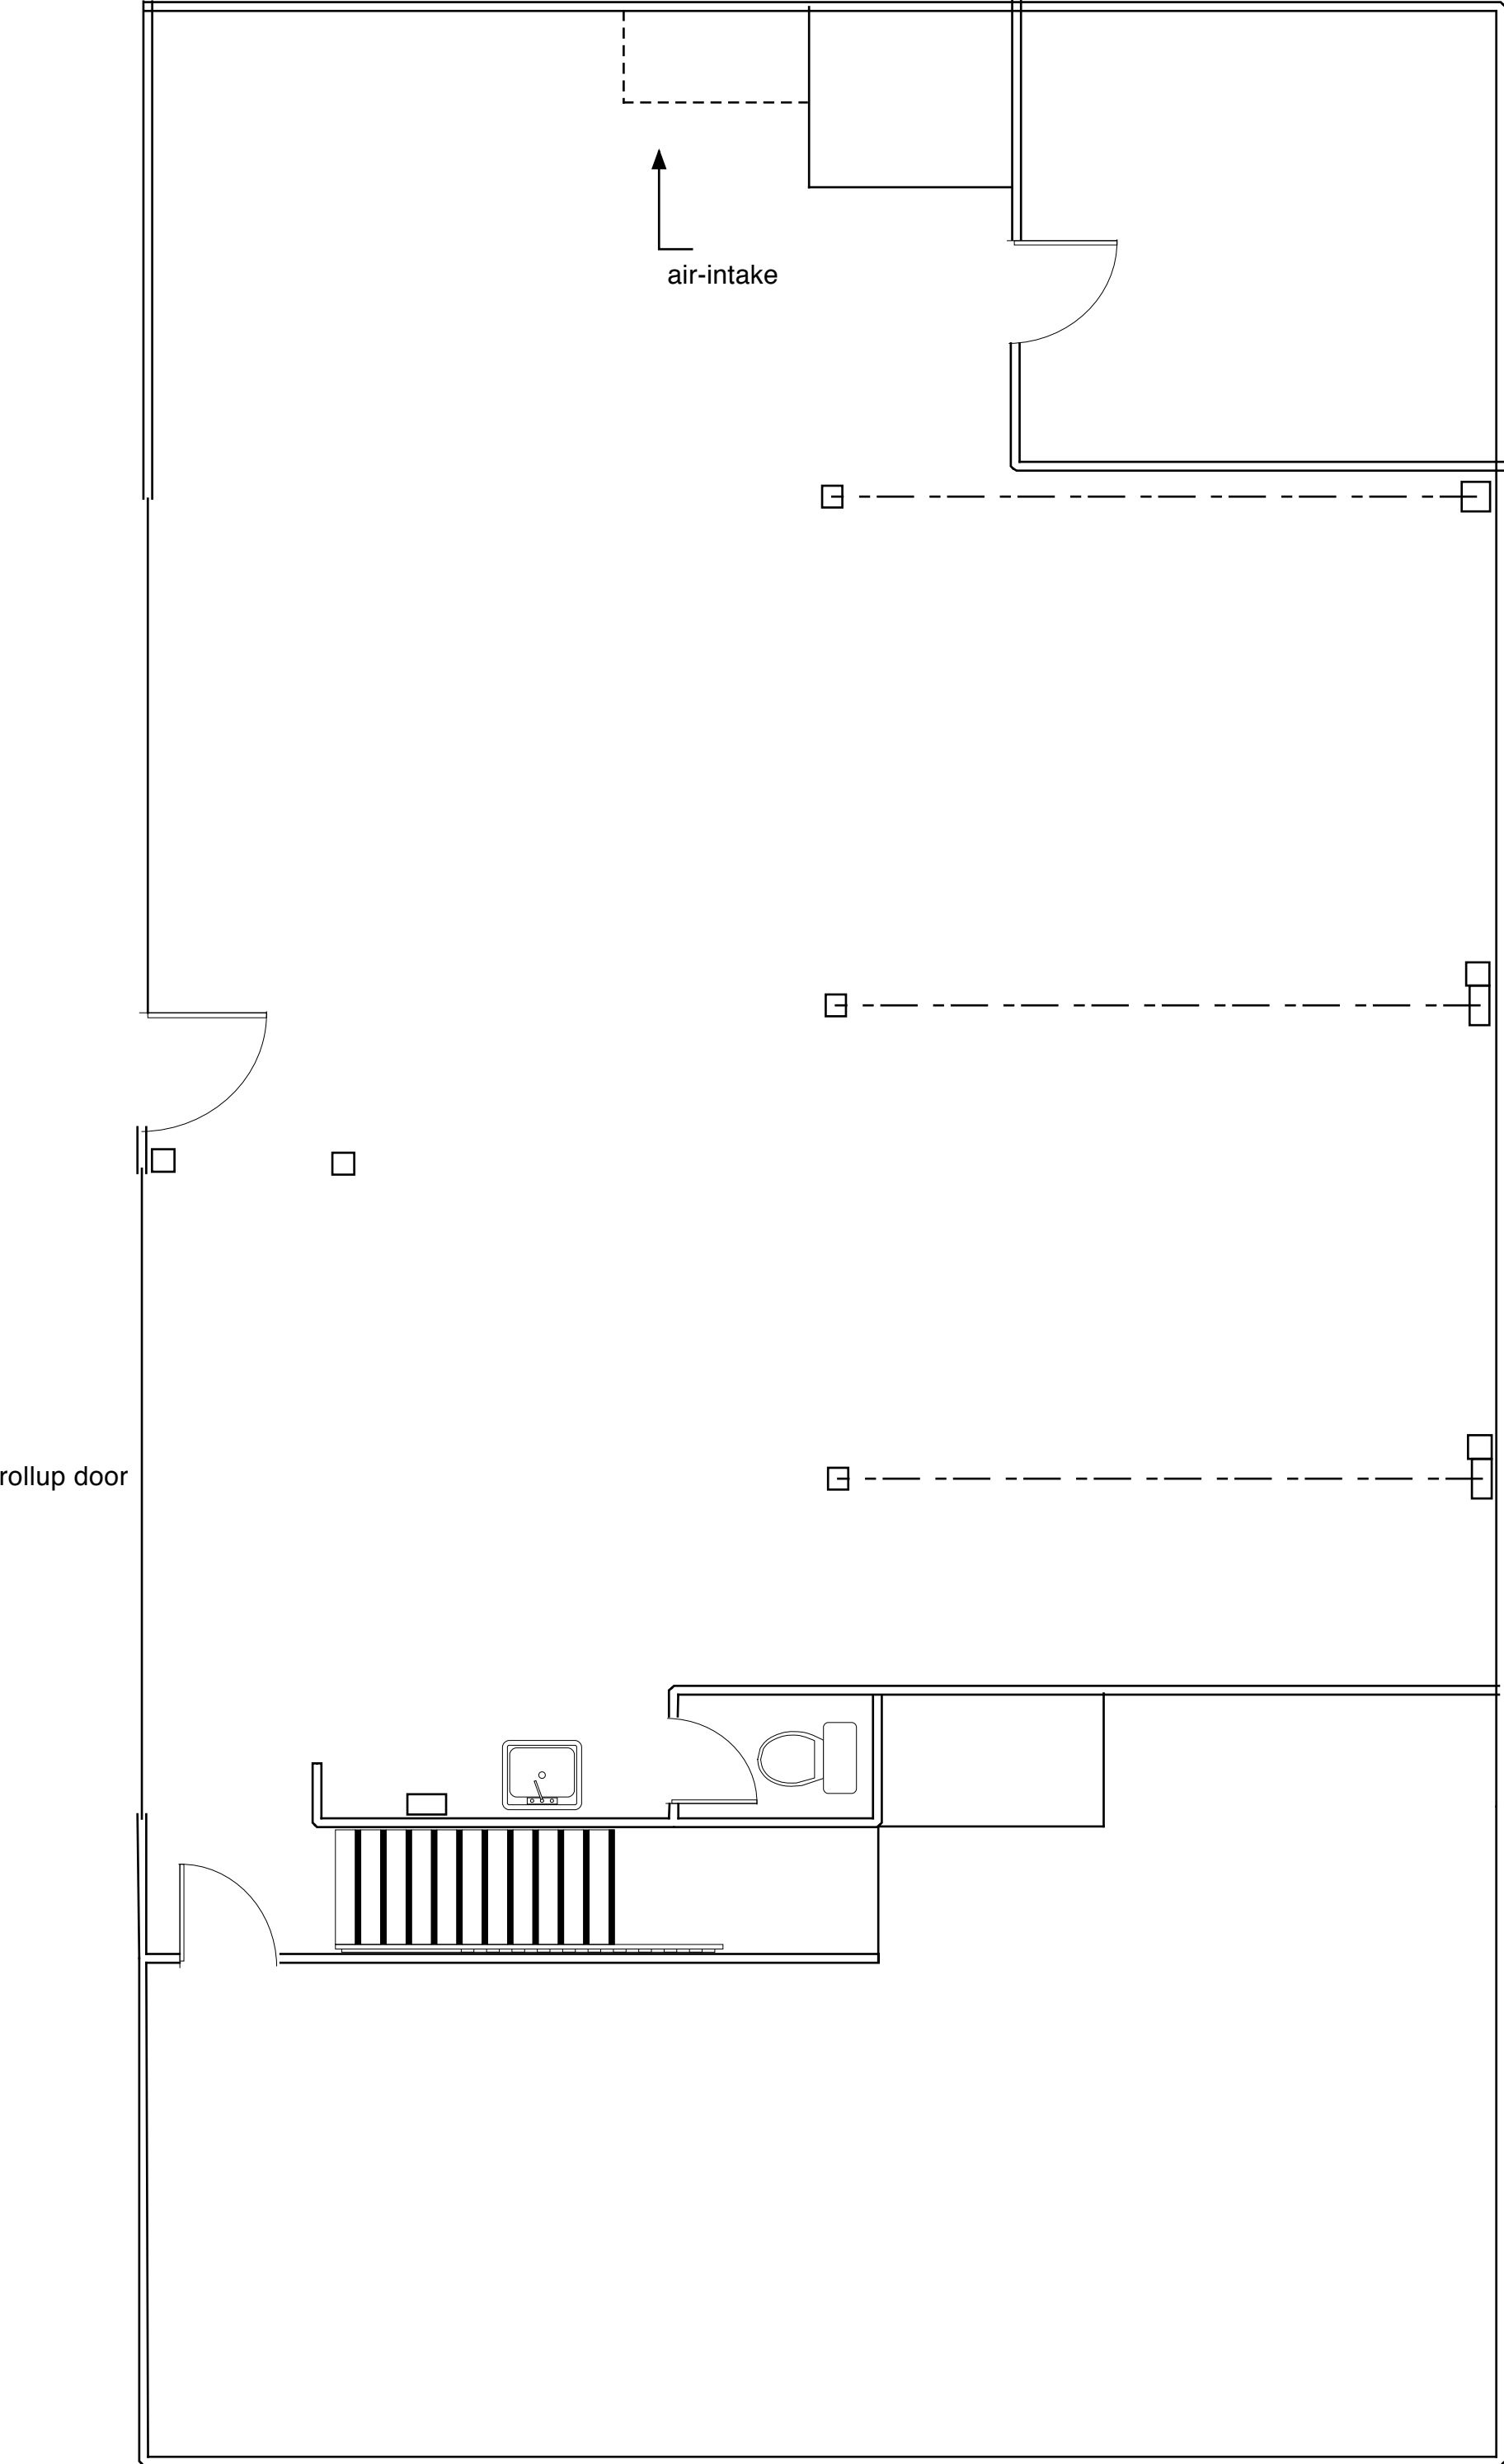

324 High Street
Interior

Version 1
august 13 2010
10.49am